


UTILITY AS-BUILT SURVEY FOR ARBOR CREEK SUBDIVISION, SECTION 4

SITUATED IN PART OF
TOWN LOT 23, TOWNSHIP 12, RANGE 4 OF THE HELPS AND GORHAM PURCHASE
TOWN OF WEBSTER
COUNTY OF MONROE
STATE OF NEW YORK

FEBRUARY 9, 2021



45 HENDRIX ROAD
WEST HENRIETTA, NY 14586
PHONE (585) 359-7540
FAX (585) 359-7547

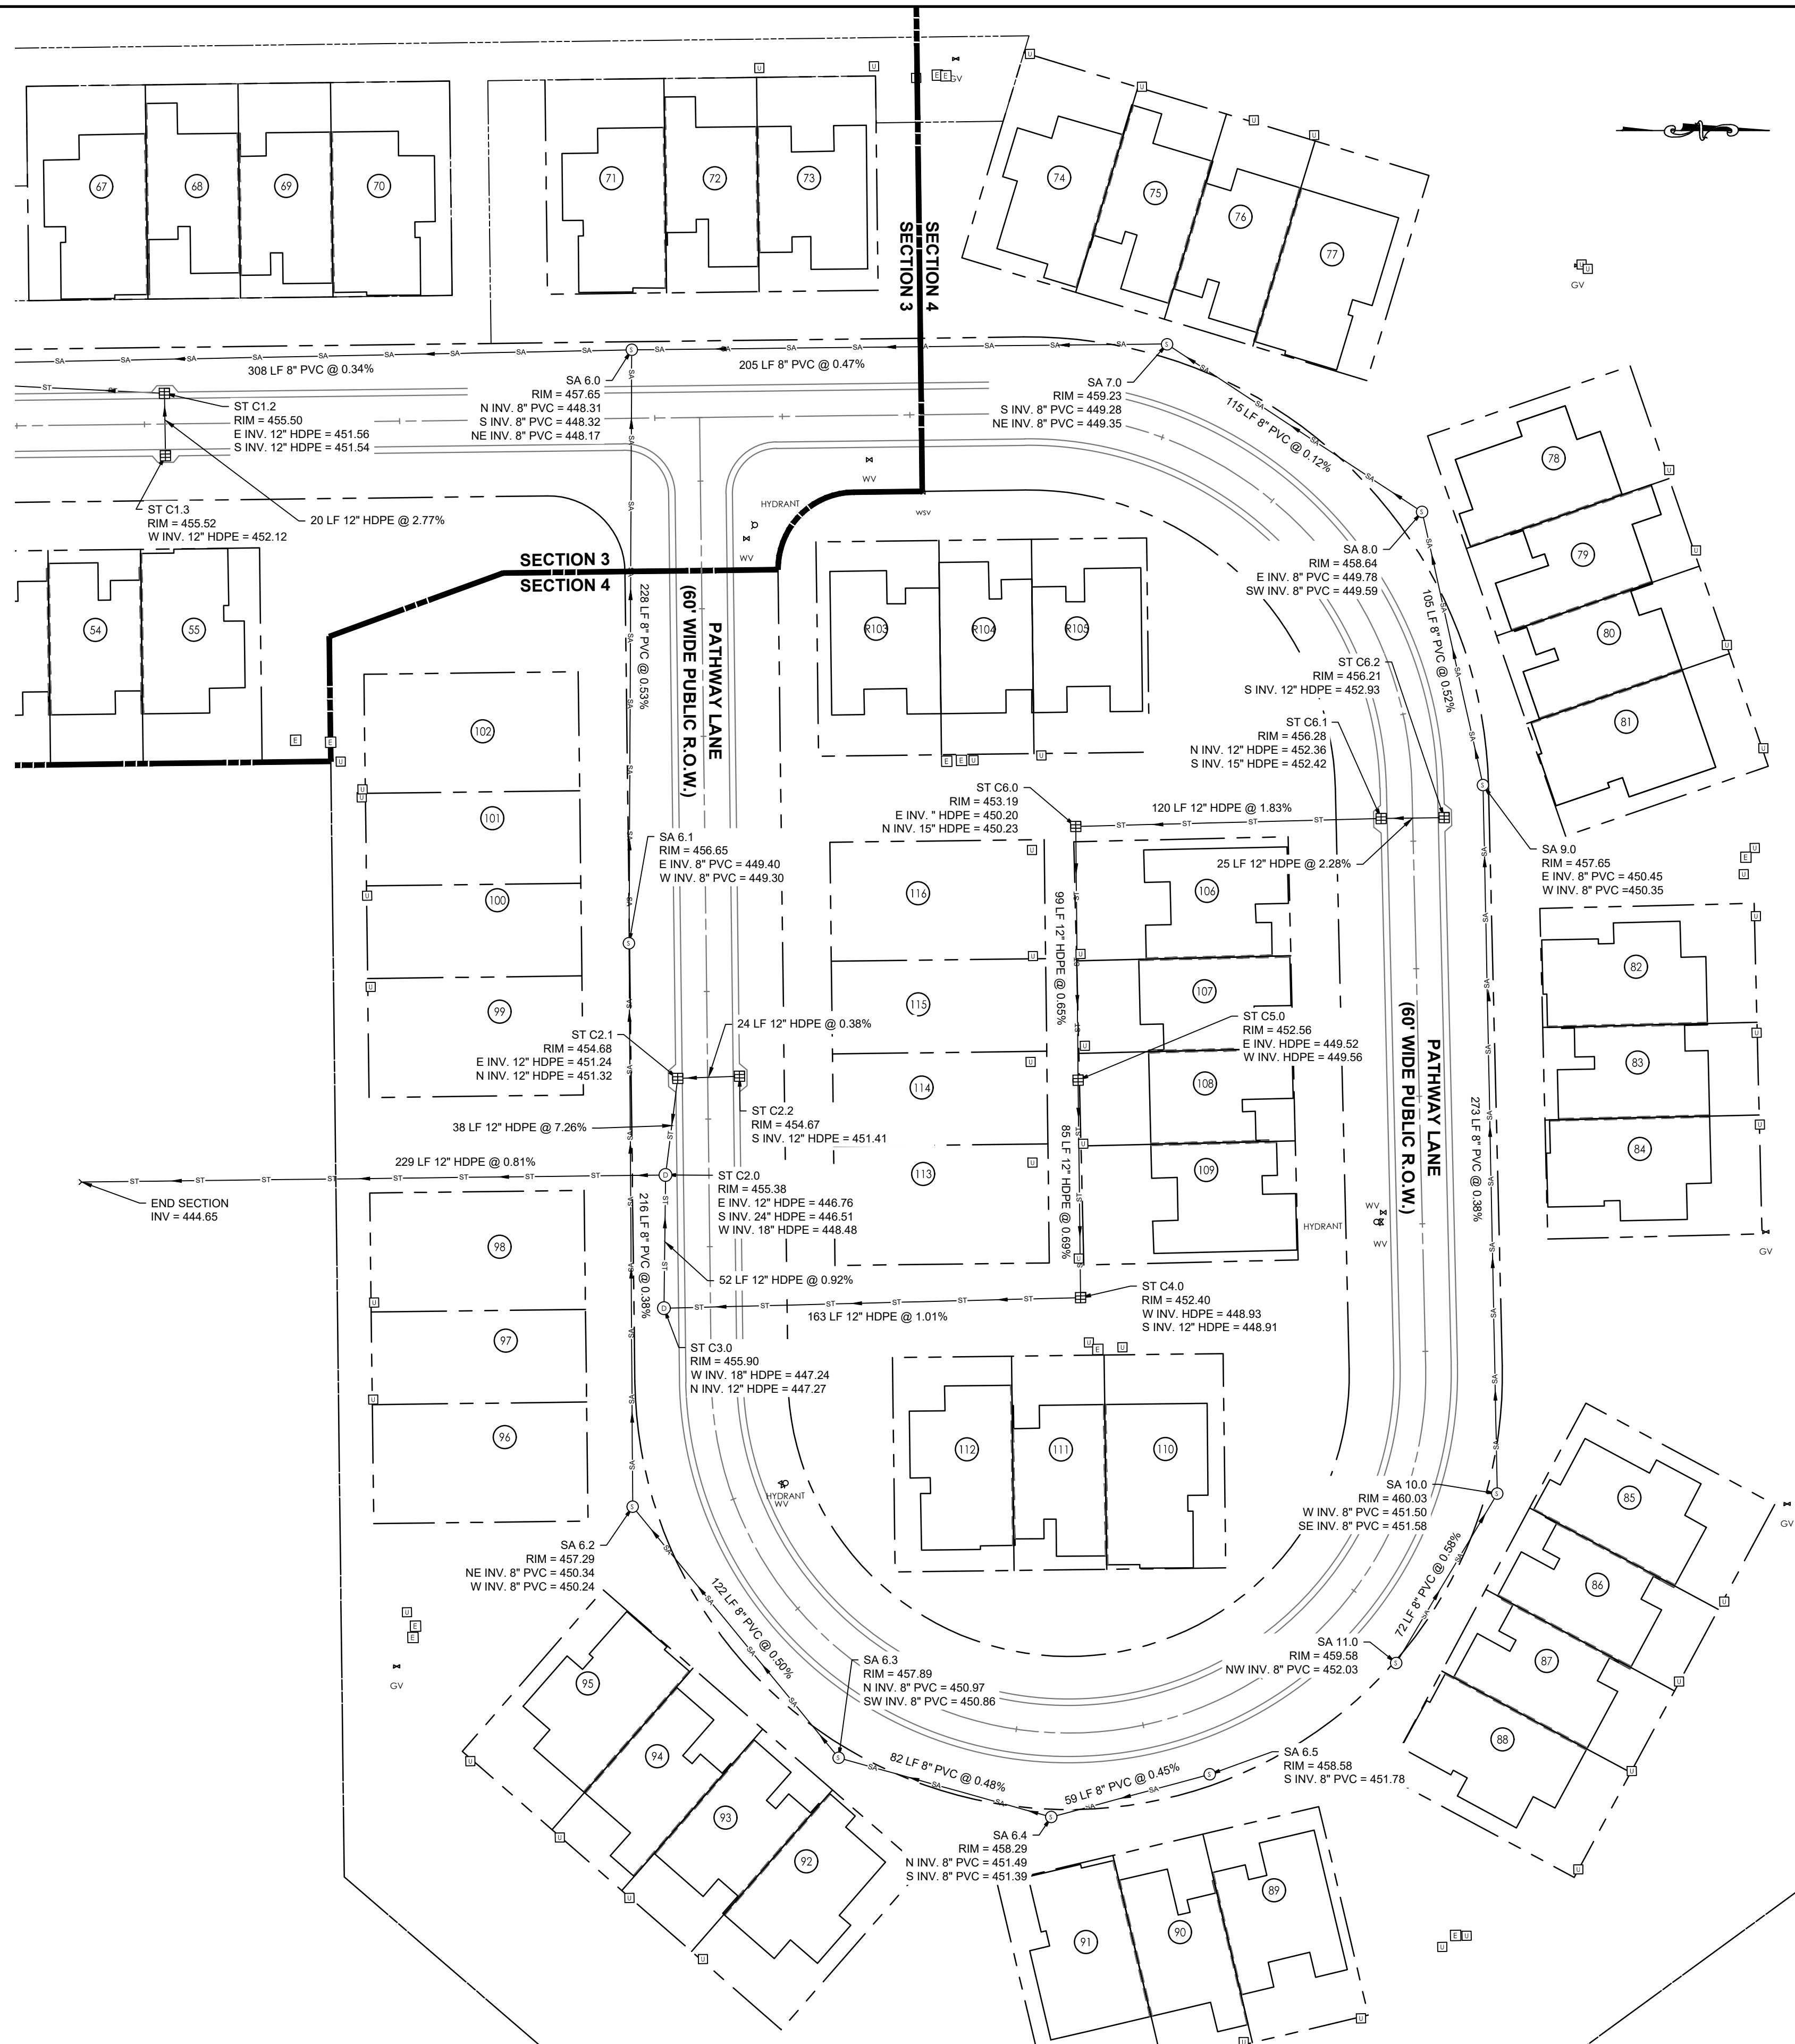

ABBREVIATIONS

EX.	EXISTING
NIF.	NOW OR FORMALLY
TYP.	TYPICAL
W/.	WITH
T.A.	TAX ACCOUNT NUMBER
REC.	PER RECORD MAPPING
CB.	CATCH BASIN
T.G.	TOP GRATE ELEVATION
MH.	MANHOLE
F.F.E.	FINISHED FLOOR ELEVATION

ELEVATION REFERENCES:

ELEVATIONS SHOWN ARE REFERENCED TO PROJECT BENCH MARK AS SHOWN ON FINAL SECTION 2 SITE PLANS FOR ARBOR CREEK TOWN HOMES PREPARED BY MARATHON ENGINEERING.

MAP REFERENCES:

LIBER 349 OF MAPS PAGE 50 & 51
LIBER 353 OF MAPS PAGE 7

LEGEND

	SUBJECT BOUNDARY LINE
	ADJOINER BOUNDARY LINE
	RIGHT-OF-WAY LINE
	EASEMENT LINE
	CENTERLINE OF RIGHT-OF-WAY
	CENTERLINE OF PAVEMENT
	CHAIN LINK FENCE LINE
	VINYL/WOOD FENCE LINE
	TREE LINE, DECIDUOUS TREE, CONIFEROUS TREE
	SANITARY LINE, CLEANOUT, MANHOLE
	STORM LINE, CATCH BASIN, MANHOLE
	WATER MAIN, VALVE, HYDRANT
	ELECTRIC LINE, METER, UTILITY PEDESTAL
	TRANSFORMER
	OVERHEAD ELECTRIC, POWERPOLE, ANCHOR
	GAS LINE, VALVE, GAS METER, FINK, LINE MARKER
	FIBER OPTIC LINE, HAND-HOLE, LINE MARKER
	AXLE, DETECT PIN, PIPE, MONUMENT, CONCRETE MONUMENT, DRILL HOLE, SET PIN
	BENCHMARK, SIGN, UTILITY MARK-OUT, BOLLARD

GRAPHIC SCALE

